


**LEGEND**


- Sewer Line
- Lot Boundary
- Stage Boundary
- Manhole / Maintenance Structure
- Existing Manhole / Maintenance Structure
- Existing Sewer Line

**ABBREVIATIONS - Sewer Main**

- Mat Material
- DSIL Down stream invert level
- USIL Up stream invert level
- SL Surface level
- L Change of slope from Manhole to Manhole

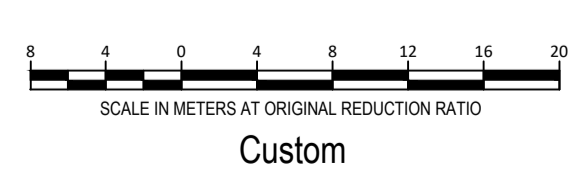

Issue	Description	Date
A	Preliminary sewer built to date	10/08/2018

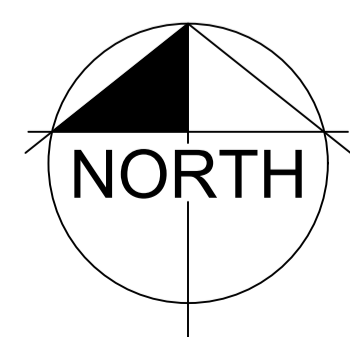

<b>PROJECT</b> Providence, Ripley	
LEVEL DATUM AHD	SCALE 1:400 @ A1
ORIGIN	Date: AUGUST 2018
	Surveyed: RPS
	Comp by: RPS
FB :	LB :
DWG:	116052s36s37Sewer

<b>CLIENT</b> AMEX CORP. PTY LTD	
<b>AS CONSTRUCTED SEWER RETICULATION STAGE 36 &amp; 37</b>	
Parish	Job Ref
Local Authority IPSWICH CITY COUNCIL	116052

RPS Australia East Pty Ltd  
ACN 140 292 762  
ABN 44 140 292 762  
180 Brisbane Street  
PO Box 341  
Ipswich QLD 4305  
T +61 7 3437 2000  
F +61 7 3434 2099  
W rpsgroup.com.au

©COPYRIGHT PROTECTS THIS PLAN. Unauthorised reproduction or amendment not permitted. Please contact the author.

Reference	Rev
<b>116052</b>	