

ENGINEER'S CERTIFICATION

I, Robert William Mander, hereby certify that:
 1. The information contained in this drawing / document is in compliance with approved drawings and design.
 2. The new water and sewerage works defined by this drawing have been designed and constructed in accordance with the SEQ Code.
 3. This represents an accurate record of as-constructed works
 4. I accept responsibility for the information contained in this drawing / document.


RPEQ (signature) RPEQ No. 12805 Date:

REGISTERED SURVEYOR'S CERTIFICATION

We RPS Australia East Pty Ltd, Registered Surveyor - Land hereby certify that the Levels and Dimensions shown hereon are a correct record of our Survey which was performed in accordance with Council Accuracy Standards.

Authorised Delegate Date:


AS CONSTRUCTED

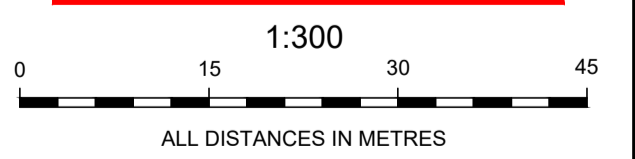

A1									
	A	10/06/2020	Preliminary Stormwater						
INDEX	DATE	REVISIONS		DRAWN	CHECKED	PASSED			

DRAWN	JB	10/06/2020
CHECKED		
PASSED		
INITIALS		DATE

RPS Australia Asia Pacific
 180 Brisbane Street
 Ipswich QLD 4305
 PO Box 341
 Ipswich QLD 4305
 (07) 3437 2000
 www.rpsgroup.com.au

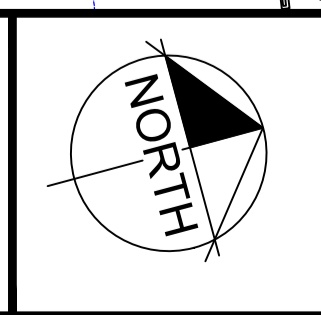

Ipswich City Council

PROVIDENCE RIPLEY
 STORMWATER RETICULATION
 STAGE 47A

SCALE 1:300
 SHEET 1 OF 1
 DRAWING NO.
 116052-280