

**LEGEND**

- Water Service
- Water Reticulation
- EXISTING Water
- Valve
- Water Meter
- Fire Hydrant
- Fitting
- Bend
- Tapping Band
- End Cap
- Tee

**ENGINEER'S CERTIFICATION**

I, Robert William Mander, hereby certify that:  
 1. The information contained in this drawing / document is in compliance with approved drawings and design.  
 2. The new water and sewerage works defined by this drawing have been designed and constructed in accordance with the SEQ Code.  
 3. This represents an accurate record of as-constructed works  
 4. I accept responsibility for the information contained in this drawing / document.


RPED (signature) RPED No. 12805 Date: \_\_\_\_\_

**REGISTERED SURVEYOR'S CERTIFICATION**

We RPS Australia East Pty Ltd, Registered Surveyor - Land hereby certify that the Levels and Dimensions shown hereon are a correct record of our Survey which was performed in accordance with Council Accuracy Standards.

Authorised Delegate \_\_\_\_\_ Date \_\_\_\_\_

**AS CONSTRUCTED**

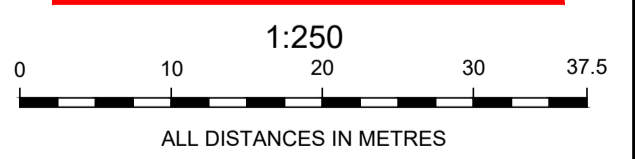

A1	03/06/2020	Preliminary Water	JB	RPS	
	REVISIONS				
INDEX	DATE	REVISIONS	DRAWN	CHECKED	PASSED

RPS Australia Asia Pacific  
 180 Brisbane Street  
 Ipswich QLD 4305  
 (07) 3437 2000  
 www.rpsgroup.com.au

**RPS**

**QUEENSLAND UrbanUtilities**

QUEENSLAND UrbanUtilities

**Queensland Urban Utilities**

PROVIDENCE RIPLEY  
 WATER RETICULATION  
 STAGE 47A

SCALE 1:250  
 SHEET 1 OF 1  
 DRAWING NO. 116052-279