

ENGINEER'S CERTIFICATION


I, Robert William Mander, hereby certify that:
 1. The information contained in this drawing / document is in compliance with approved drawings and design.
 2. The new water and sewerage works defined by this drawing have been designed and constructed in accordance with the SEQ Code.
 3. This represents an accurate record of as-constructed works.
 4. I accept responsibility for the information contained in this drawing / document.

RPEQ (signature) RPEQ No. 12805 Date: _____

REGISTERED SURVEYOR'S CERTIFICATION

We RPS Australia East Pty Ltd, Registered Surveyor - Land hereby certify that the Levels and Dimensions shown hereon are a correct record of our Survey which was performed in accordance with Council Accuracy Standards.


Authorised Delegate Date _____

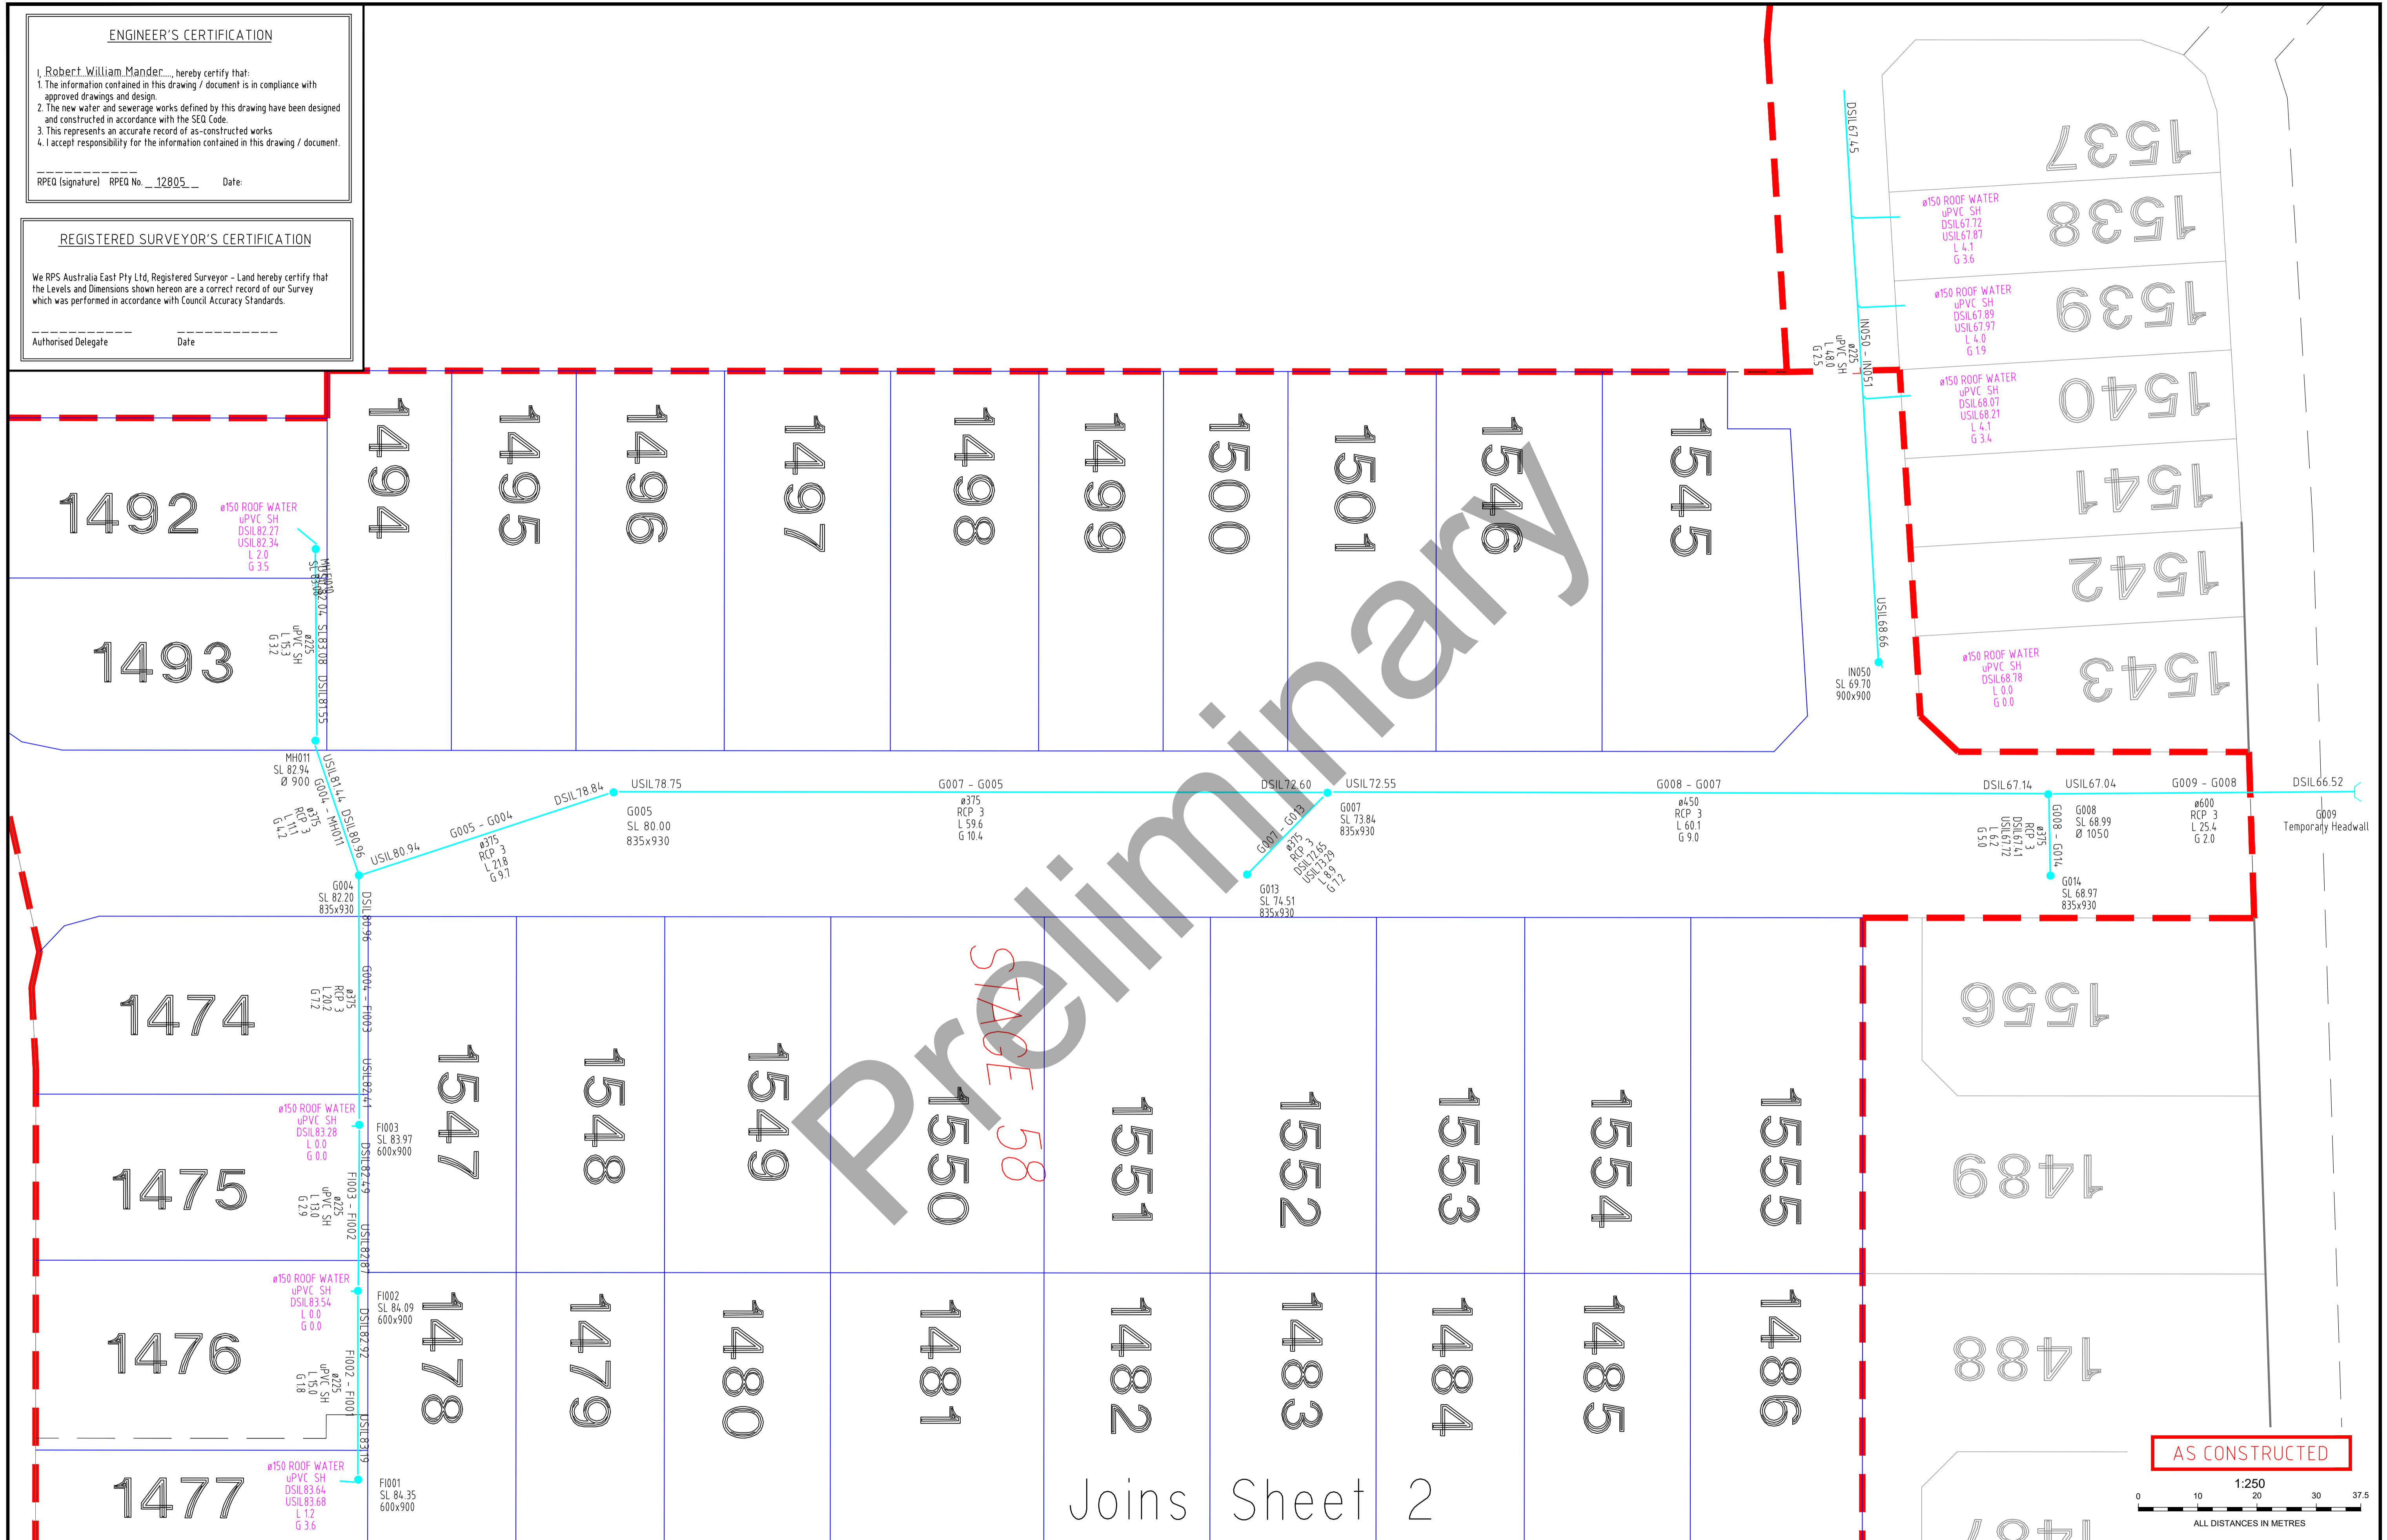

STAGE 58

Joins Sheet 2



AS CONSTRUCTED

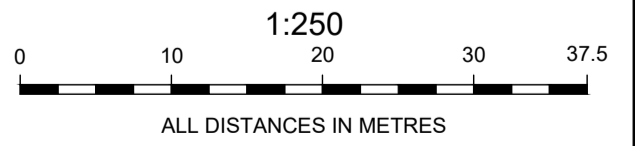

| | | | | | | |
|----|-------|------------|-------------------------|-------|---------|--------|
| A1 | INDEX | DATE | REVISIONS | DRAWN | CHECKED | PASSED |
| | A | 12/11/2020 | Preliminary Storm Water | AJP | RPS | |

| | | |
|----------|-----|------------|
| DRAWN | AJP | 12/11/2020 |
| CHECKED | RPS | 12/11/2020 |
| PASSED | | |
| INITIALS | | DATE |

RPS Australia Asia Pacific
 180 Brisbane Street PO Box 341
 Ipswich QLD 4305
 (07) 3437 2000
 www.rpsgroup.com.au

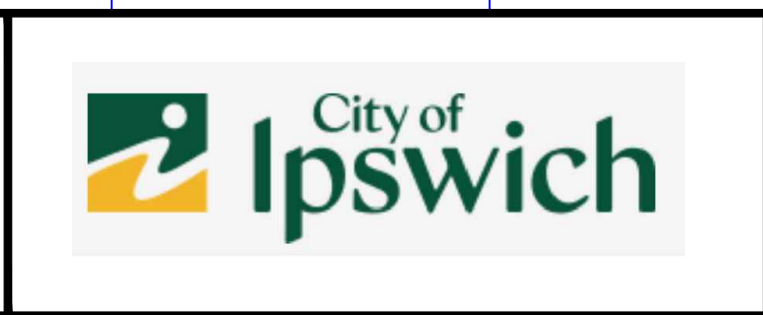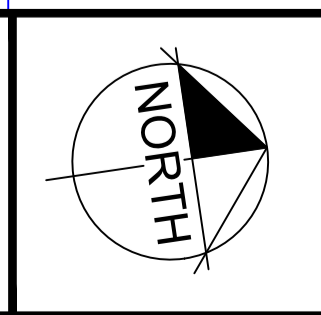

Ipswich City Council
 PROVIDENCE RIPLEY
 PRELIMINARY ONLY STORM WATER
 STAGE 58

| | |
|-------------|------------|
| SCALE | 1:250 |
| SHEET | 1 OF 2 |
| DRAWING NO. | 116052-292 |

Joins Sheet 1

ENGINEER'S CERTIFICATION


I, Robert William Mander, hereby certify that:
 1. The information contained in this drawing / document is in compliance with approved drawings and design.
 2. The new water and sewerage works defined by this drawing have been designed and constructed in accordance with the SEQ Code.
 3. This represents an accurate record of as-constructed works.
 4. I accept responsibility for the information contained in this drawing / document.

RPEQ (signature) RPEQ No. 12805 Date:


REGISTERED SURVEYOR'S CERTIFICATION

We RPS Australia East Pty Ltd, Registered Surveyor - Land hereby certify that the Levels and Dimensions shown hereon are a correct record of our Survey which was performed in accordance with Council Accuracy Standards.

Authorised Delegate Date

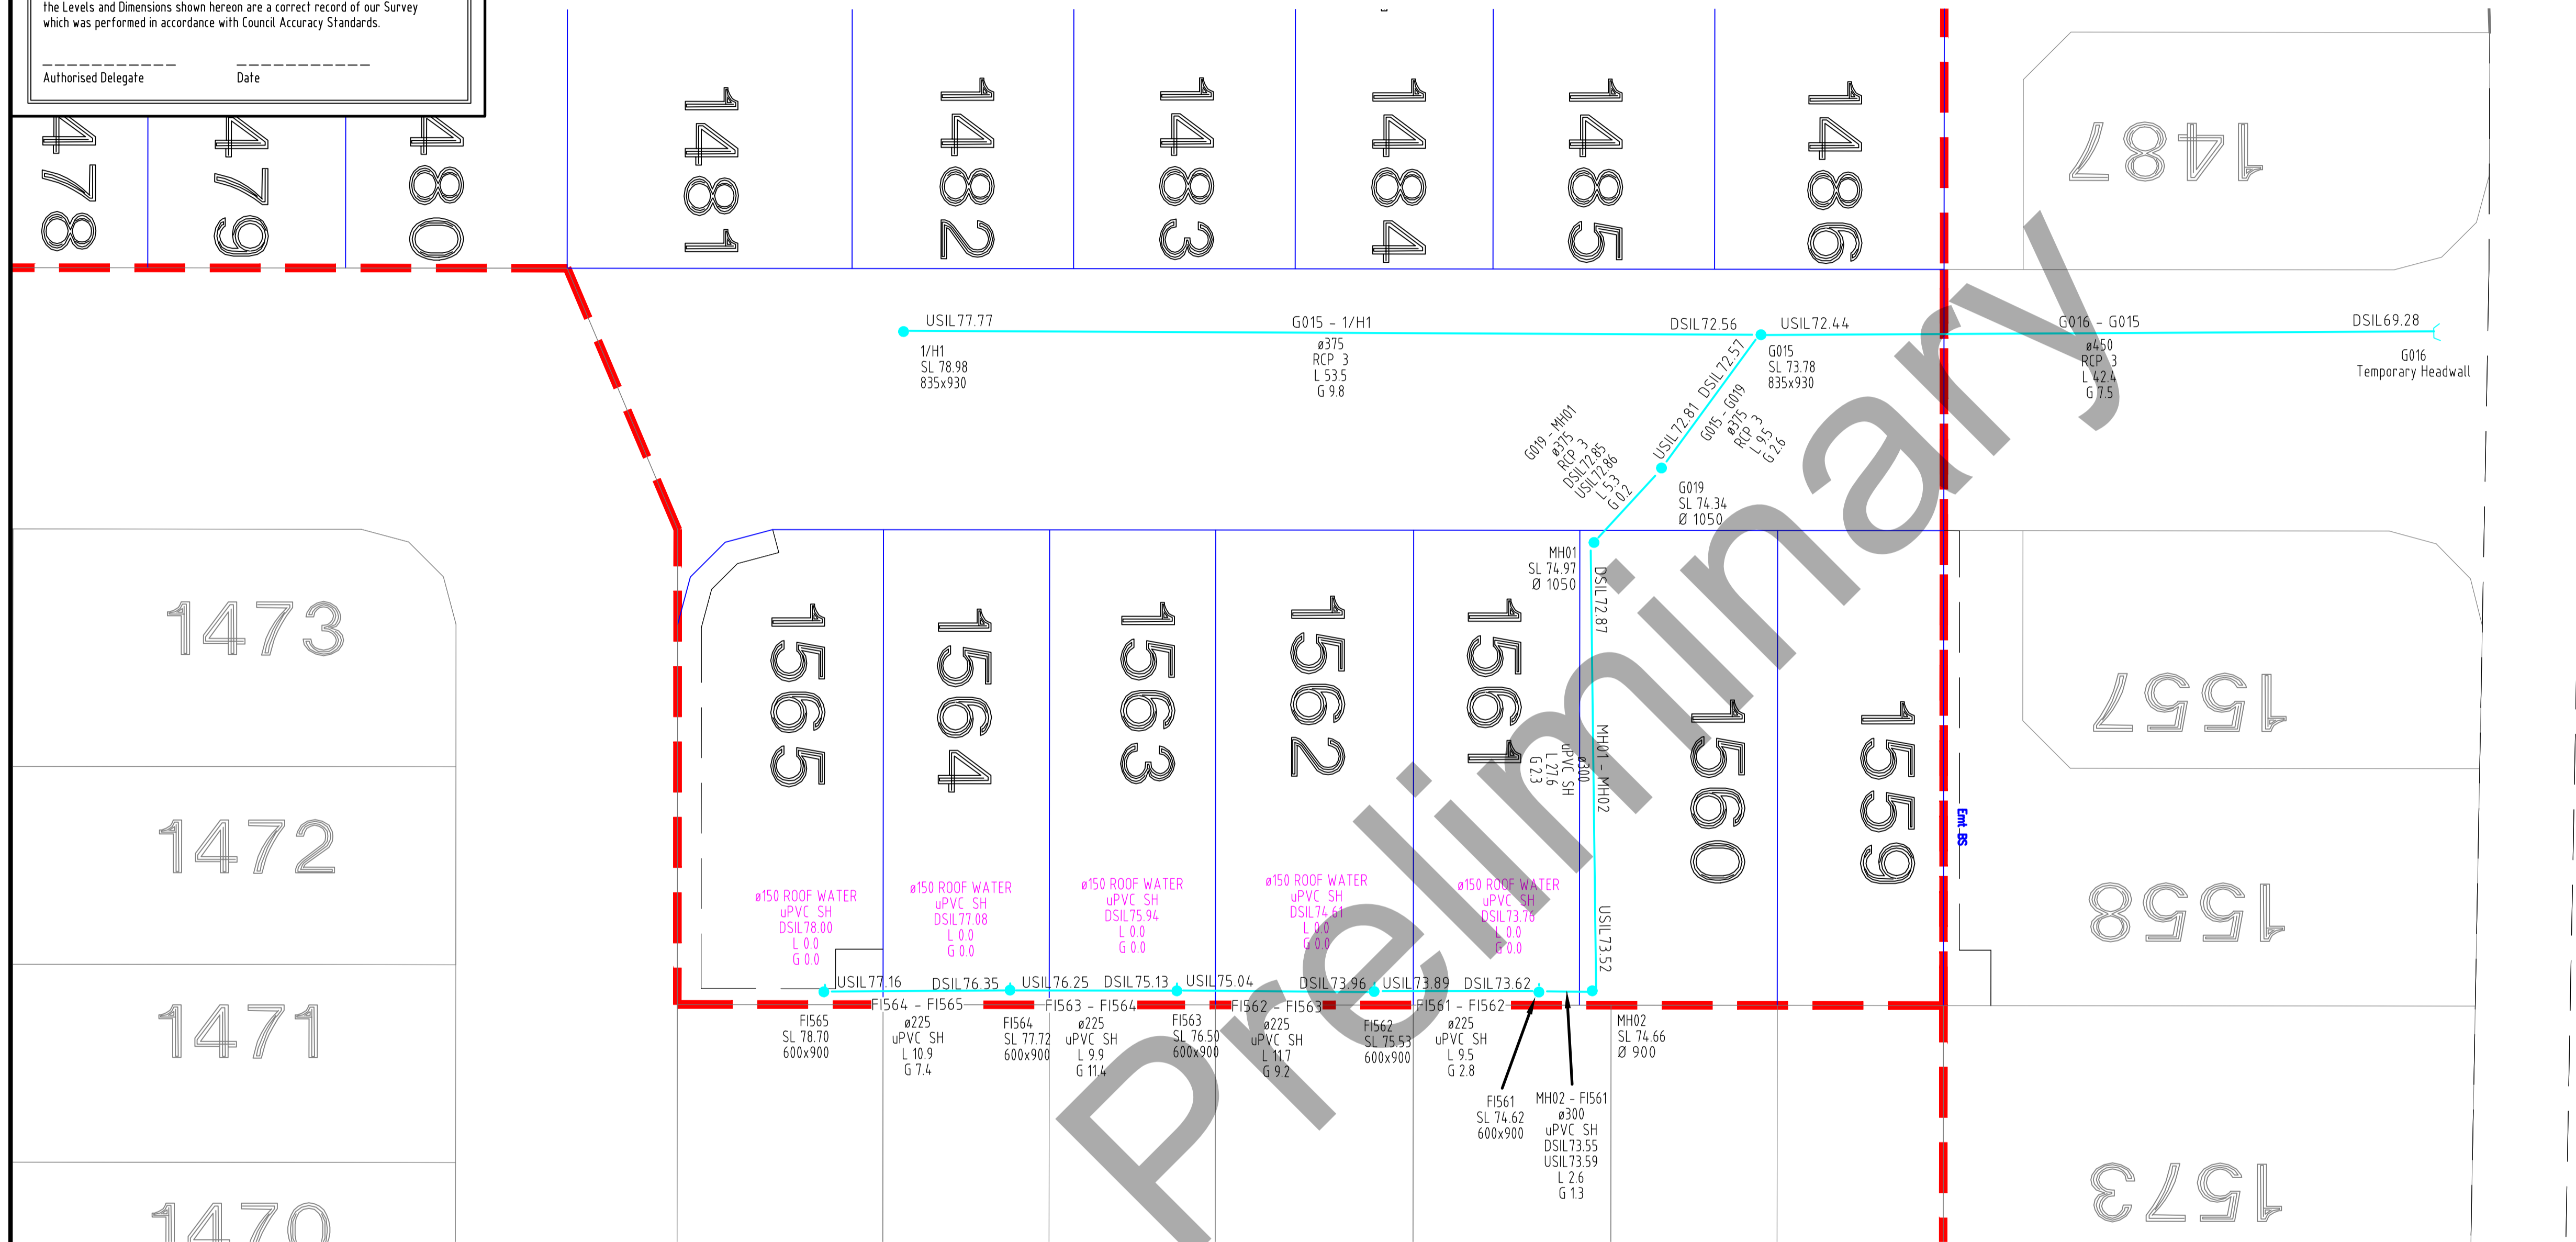



AS CONSTRUCTED

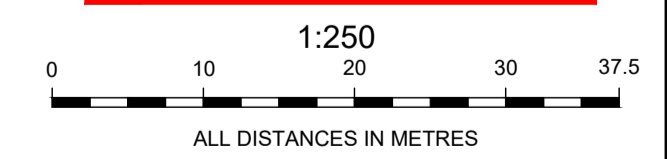

| | | | | | | |
|----|-------|------------|-------------------------|-------|---------|--------|
| A1 | INDEX | DATE | REVISIONS | DRAWN | CHECKED | PASSED |
| | A | 12/11/2020 | Preliminary Storm Water | AJP | RPS | |

| | | |
|----------|-----|------------|
| DRAWN | AJP | 12/11/2020 |
| CHECKED | RPS | 12/11/2020 |
| PASSED | | |
| INITIALS | | DATE |

RPS Australia Asia Pacific
 180 Brisbane Street
 Ipswich
 QLD 4305
 (07) 3437 2000
 www.rpsgroup.com.au

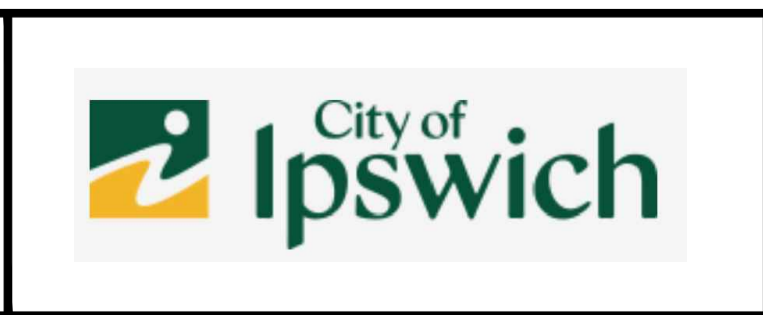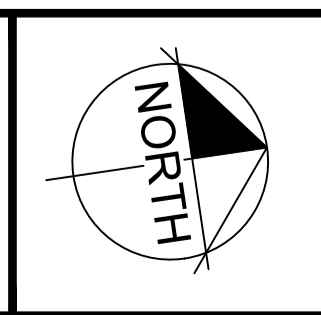

Ipswich City Council
 PROVIDENCE RIPLEY
 PRELIMINARY ONLY STORM WATER
 STAGE 58

| | |
|-------------|------------|
| SCALE | 1:250 |
| SHEET | 2 OF 2 |
| DRAWING NO. | 116052-292 |