


STAGE 55A

STAGE 55B

STAGE 46

AS CONSTRUCTED

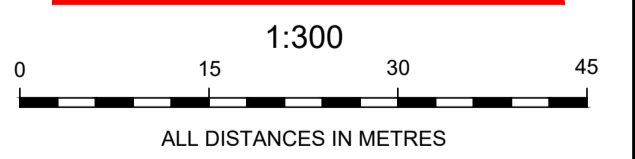



ENGINEER'S CERTIFICATION
 I, Willie Maherbe, hereby certify that:
 1. The information contained in this drawing / document is in compliance with approved drawings and design.
 2. The new water and sewerage works defined by this drawing have been designed and constructed in accordance with the SEQ Code.
 3. This represents an accurate record of as-constructed works
 4. I accept responsibility for the information contained in this drawing / document.
 RPEQ (signature) RPEQ No. 8112 Date:

REGISTERED SURVEYOR'S CERTIFICATION
 We RPS Australia East Pty Ltd, Registered Surveyor - Land hereby certify that the Levels and Dimensions shown hereon are a correct record of our Survey which was performed in accordance with Council Accuracy Standards.
 Authorised Delegate Date:

A1	B	12/07/2019	Stormwater for review	JG		
	A	10/05/2019	Preliminary Stormwater	JG	RPS	
INDEX	DATE	REVISIONS		DRAWN	CHECKED	PASSED

DRAWN	JG	10/05/2019
CHECKED	JG	10/05/2019
PASSED		
INITIALS		DATE

RPS Australia Asia Pacific
 180 Brisbane Street
 Ipswich
 QLD 4305
 (07) 3437 2000
 www.rpsgroup.com.au

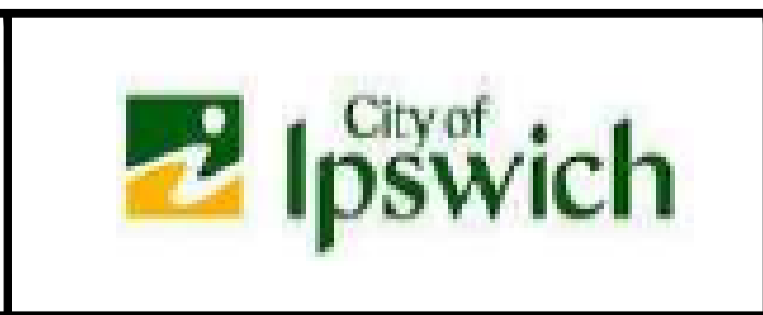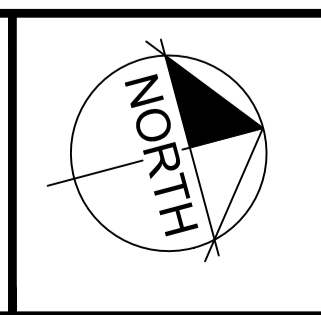

Ipswich City Council
 PROVIDENCE RIPLEY
 STORMWATER RETICULATION
 STAGE 46

SCALE	1:300
SHEET	1 OF 1
DRAWING NO.	116052