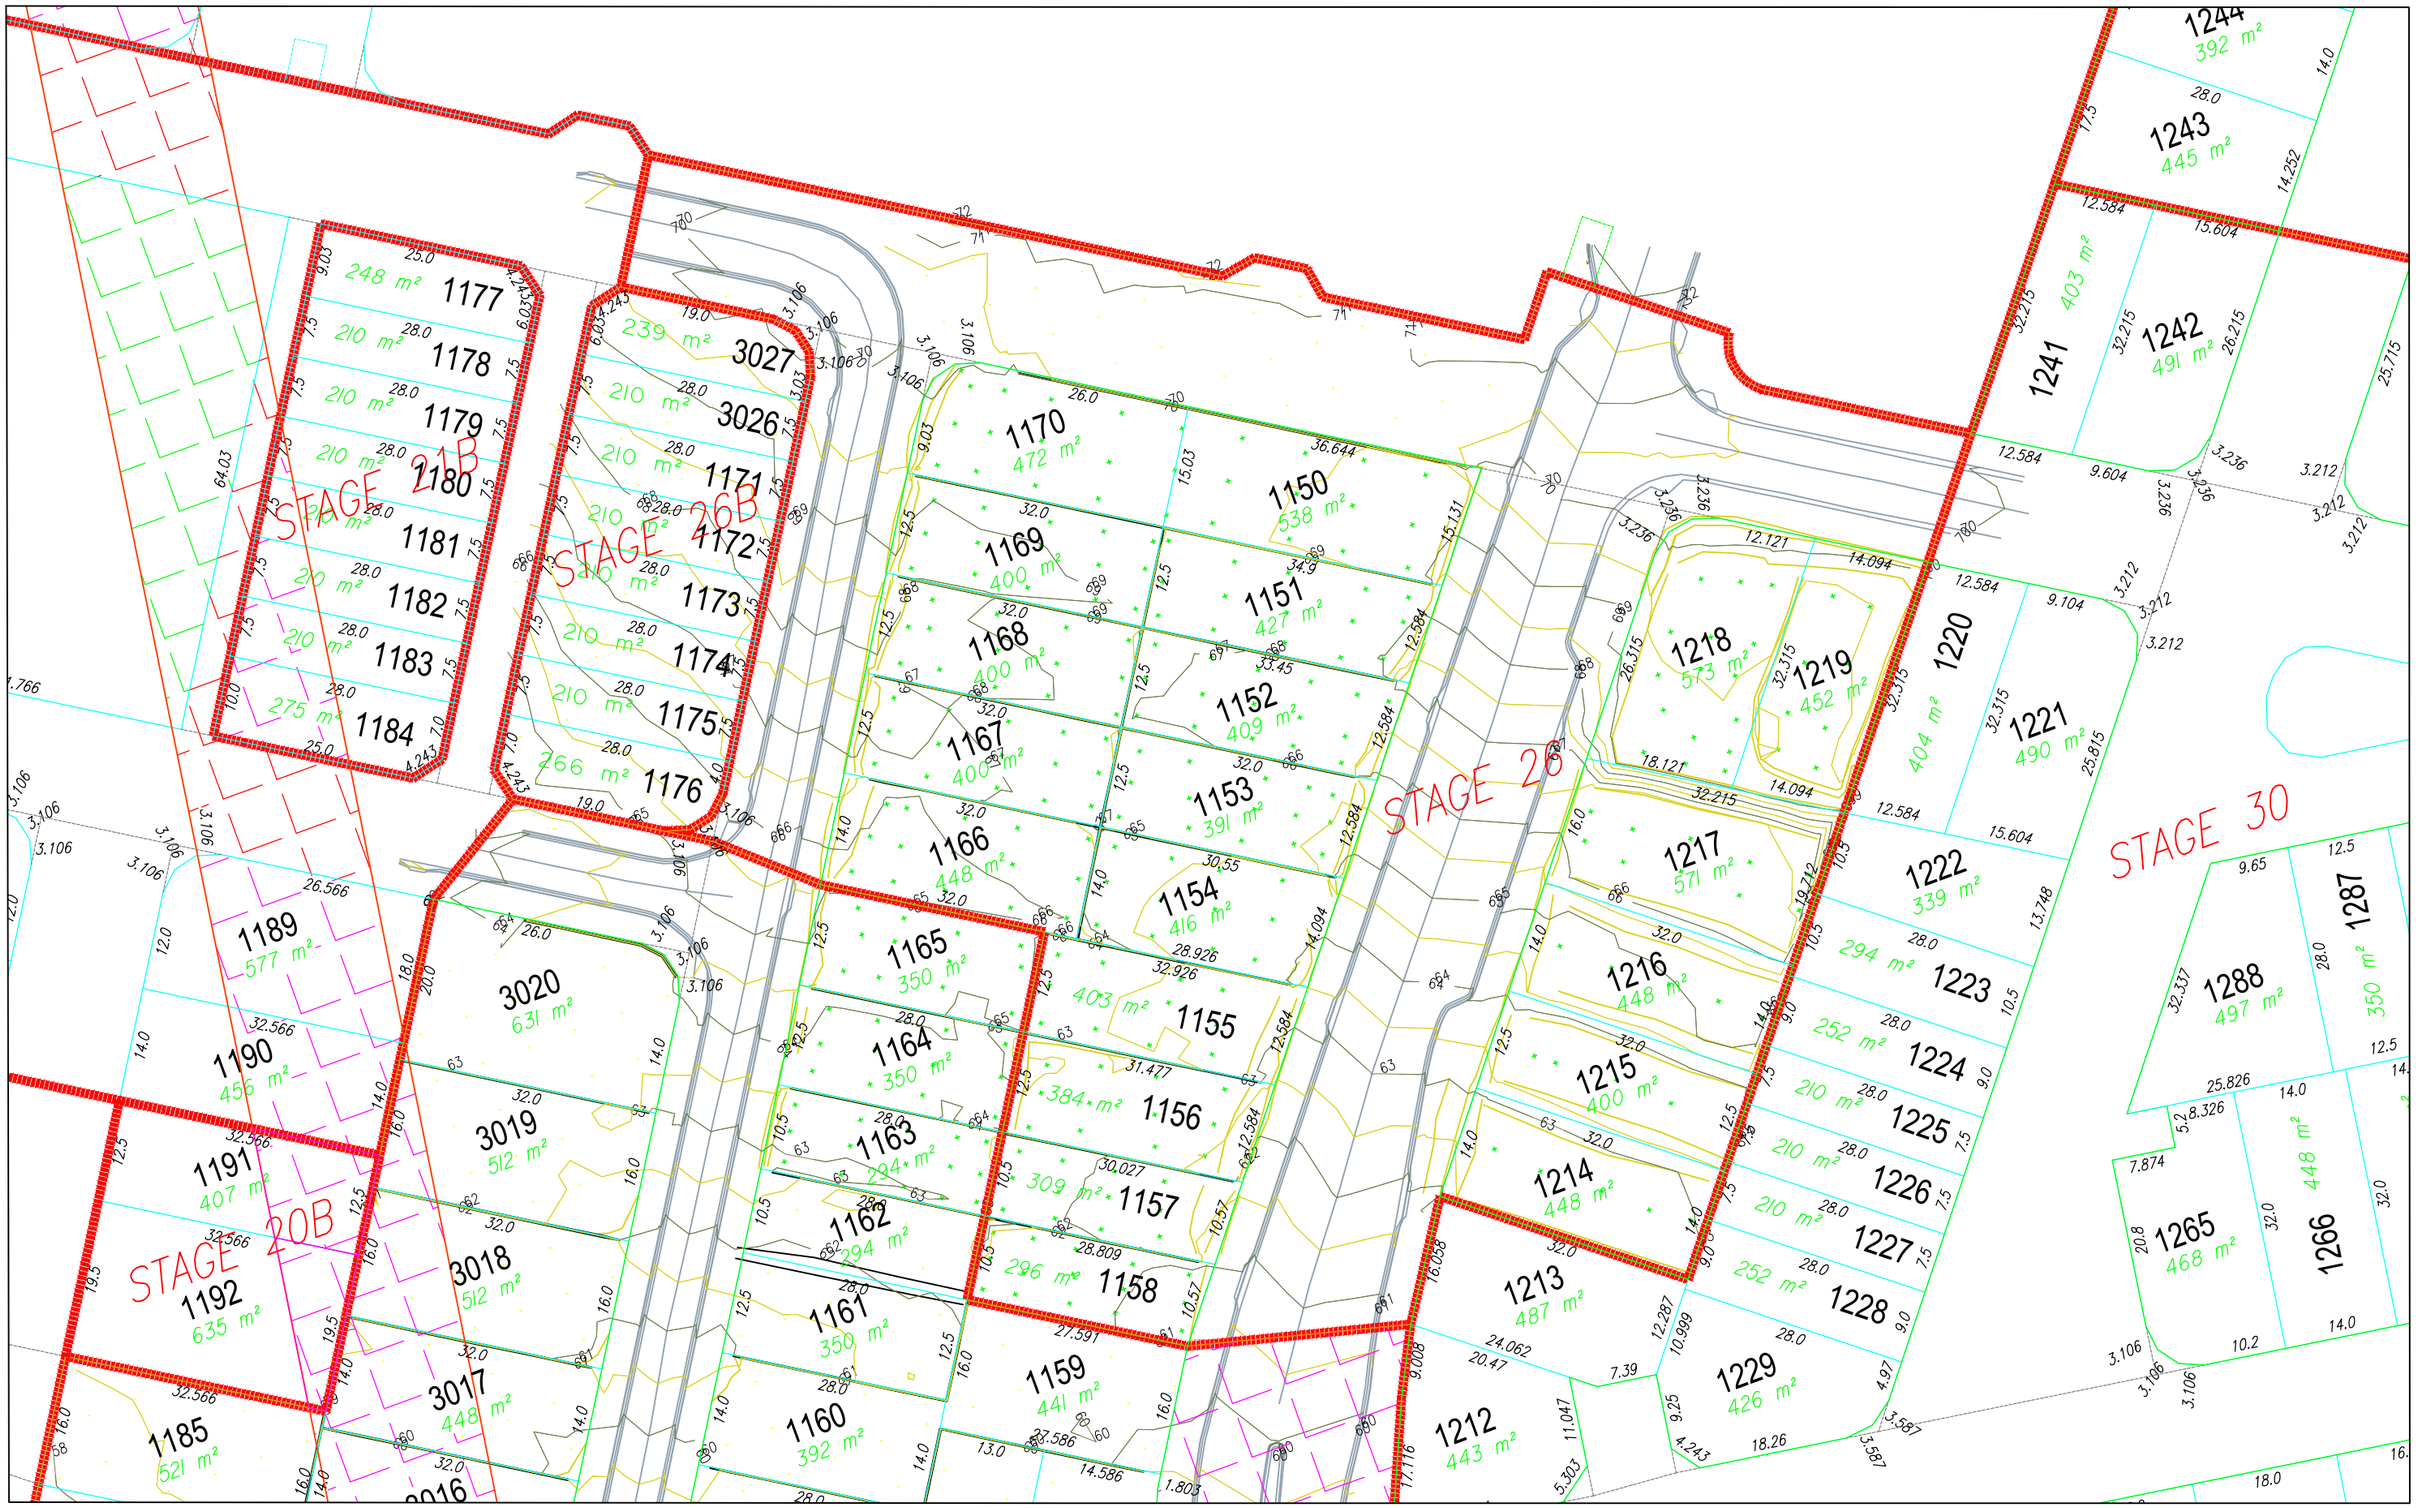

Amendment	Description	Date	Surveyor	Drafted

Hz Datum:	----	Locality:	Ripley
Hz Origin:	----	Local Authority:	Ipswich City
Vrt Datum:	----	Lat Long:	----
Vrt Origin:	----	DWG:	116052s26s27_Postfill
Origin RL:	----m	12D:	Stage 26 27 Postfill

PAGE SIZE A3

SCALE 1:750

15 7.5 0 7.5 15 22.51 30.01 37.51

SCALE IN METERS AT ORIGINAL REDUCTION RATIO

CLIENT AMEX Corportation

RPS Australia Asia Pacific
180 Brisbane Street Ipswich QLD 4305
PO Box 341 Ipswich QLD 4305
t (07) 3437 2000
www.rpsgroup.com.au

PROJECT Providence Ripley

As-Constructed Post Fill
Stage 26

© Copyright protects this plan

SHEET 1 OF 1 | PR116052 | 155