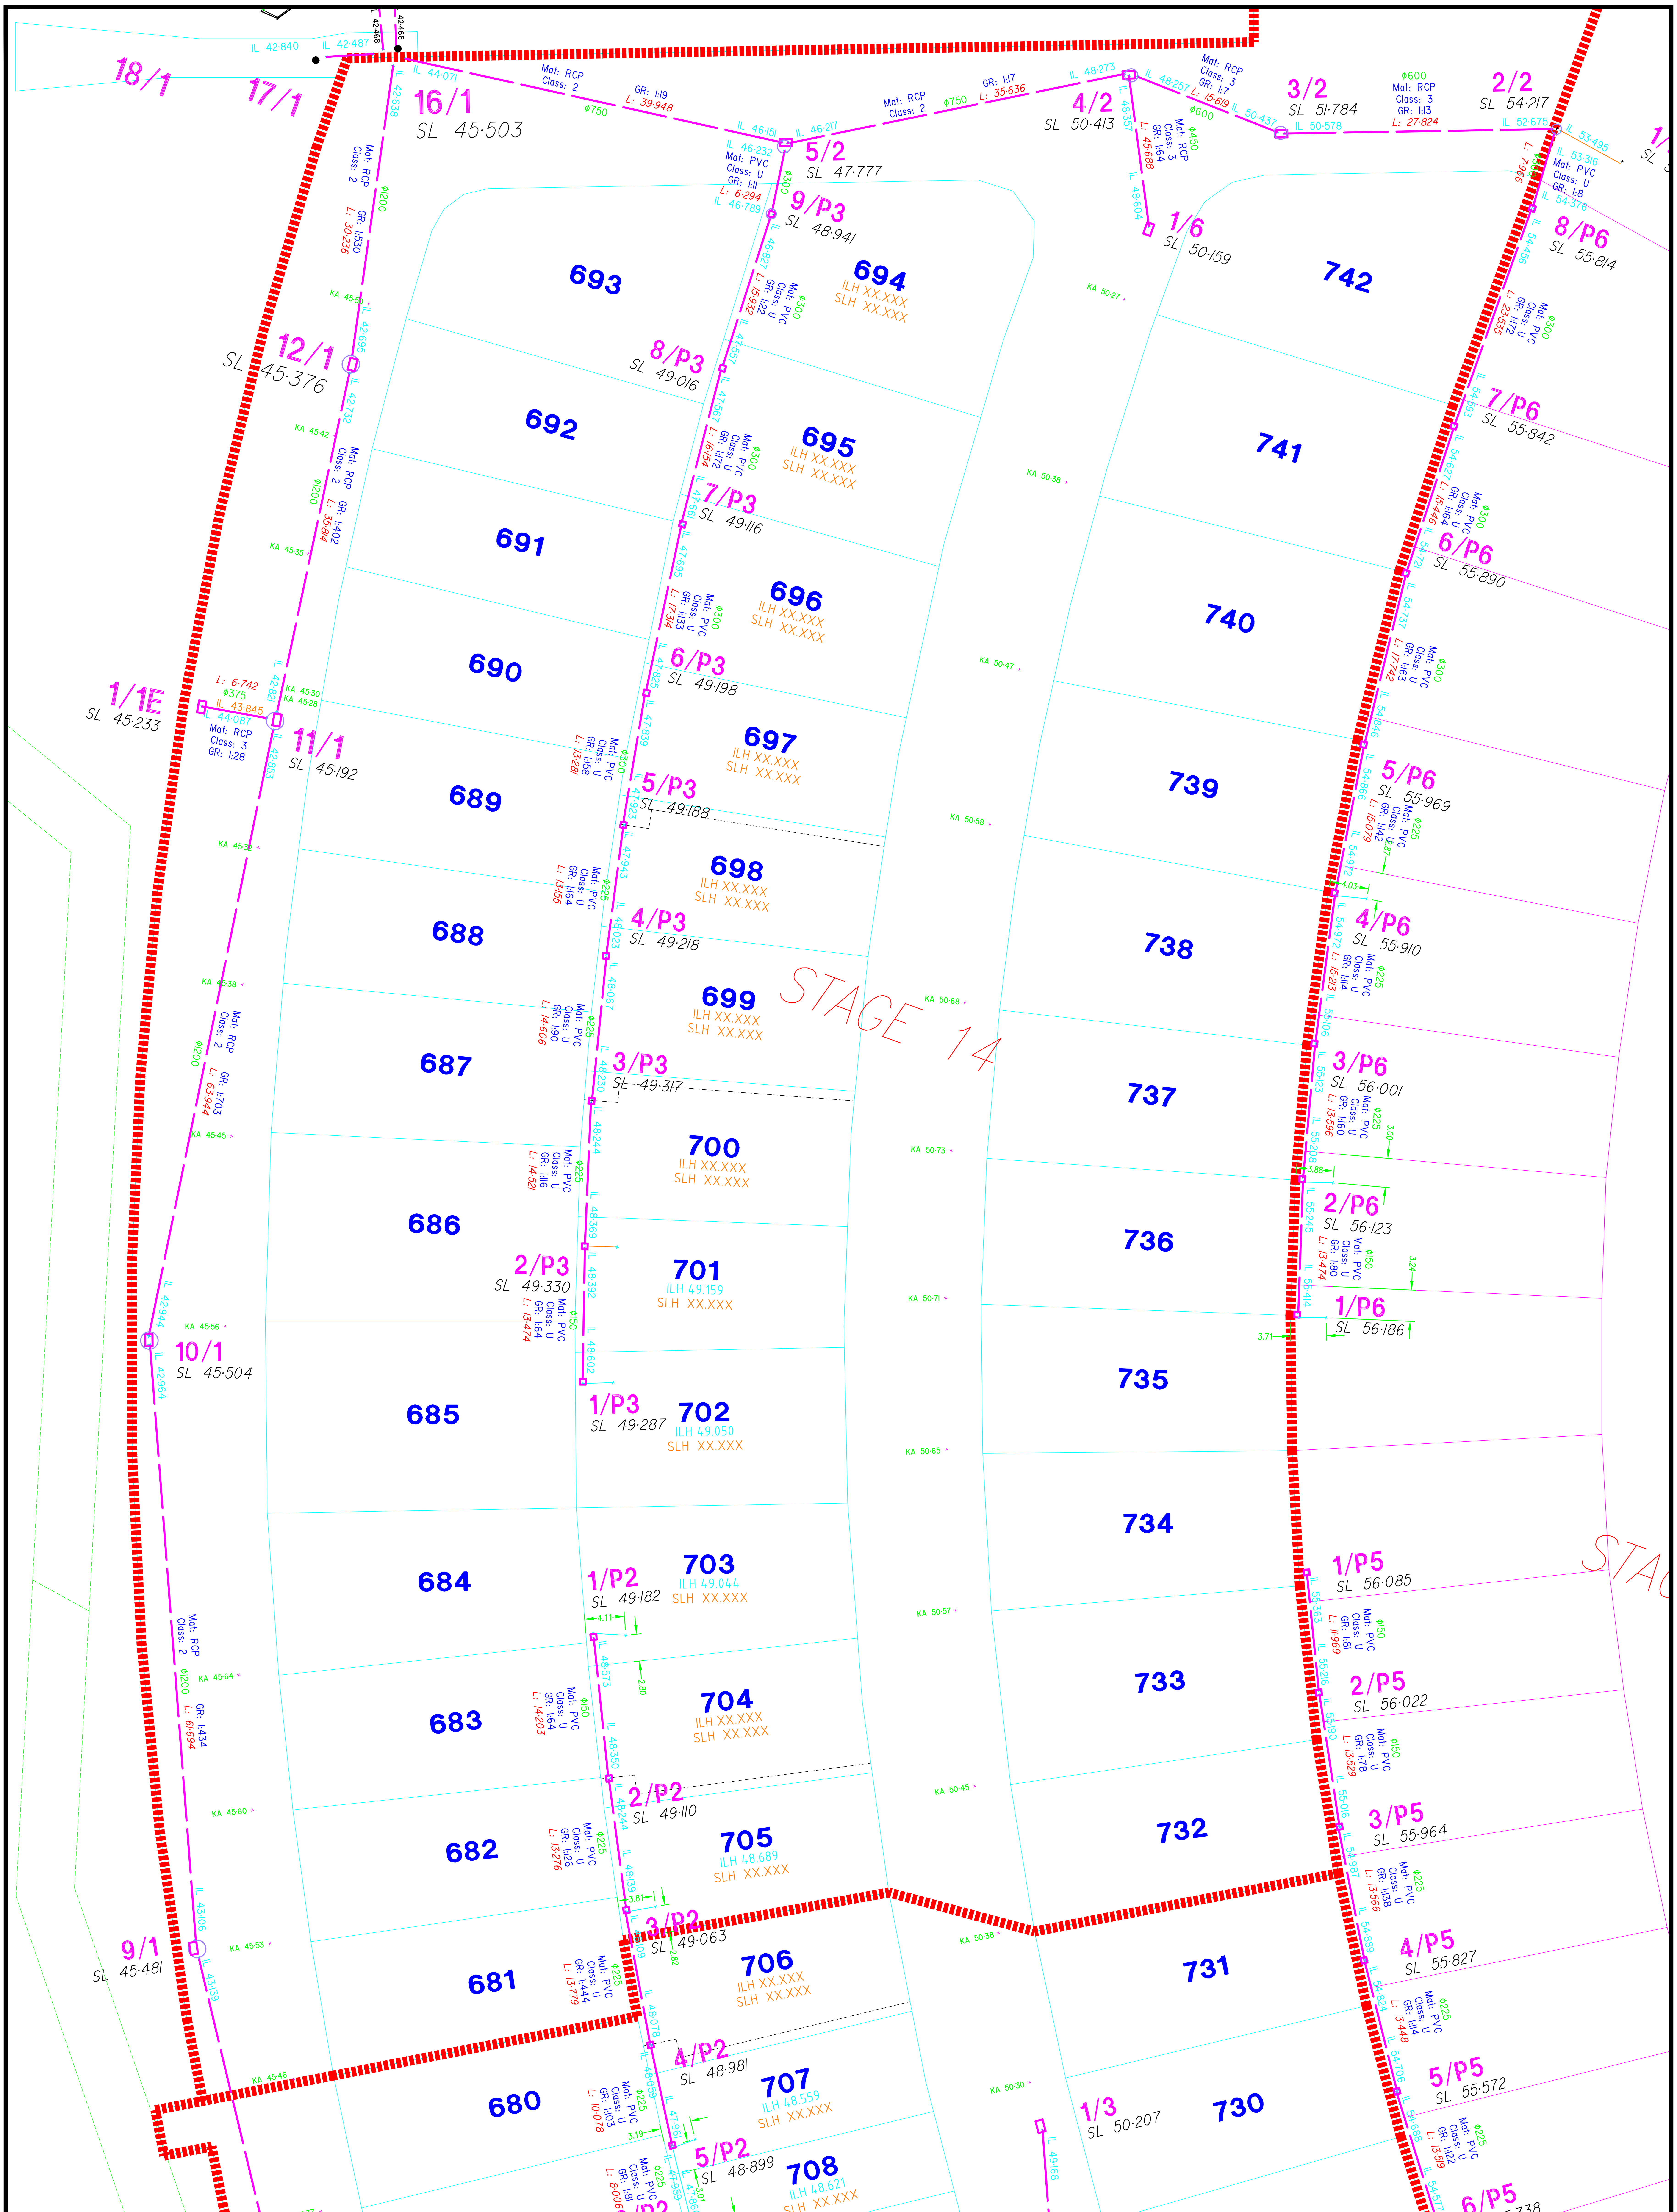

SURVEY DATUM

Coordinate System: Local Site.
Horizontal Azimuth: GDA94
Vertical Datum: AHD71

0 5 10 15 20 25
Scale of Metres

BUILDERS ISSUE

NORTH

PROJECT	*Providence, Ripley*		
LEVEL DATUM AHD	SCALE 1:300 @ A1		
ORIGIN OPM60301 RL 44·315 Barrams Rd Sth Ripley	Date MAY 2016		
	Surveyed RPS		
	Comp by DJL		
FB : TSC3	LB :	DWG 116052 Stormwater	

CLIENT

AMEX CORP. PTY LTD

AS CONSTRUCTED
STORMWATER MAINS
STAGE 14

Parish		Job Ref
Local Authority	IPSWICH CITY COUNCIL	116052

RPS

©COPYRIGHT PROTECTS THIS PLAN
Unauthorised reproduction or amendment not permitted. Please contact the author.

RPS Australia East Pty Ltd
ACN 140 292 762
ABN 44 140 292 762
180 Brisbane Street
PO Box 341
Ipswich QLD 4305
T +61 7 3437 2000
F +61 7 3434 2099
W rpsgroup.com.au

Reference **116052-88** Rev